

THIS DRAWING CONTAINS TANGENT ENVIRONMENTAL TECHNOLOGIES PROPRIETARY AND CONFIDENTIAL INFORMATION AND IS LOANED FOR LIMITED PURPOSES ONLY AND REMAINS THE PROPERTY OF TANGENT ENVIRONMENTAL TECHNOLOGIES. IT MAY NOT BE REPRODUCED IN WHOLE OR IN PART WITHOUT THE WRITTEN PERMISSION OF TANGENT ENVIRONMENTAL TECHNOLOGIES AND MUST NOT BE DISCLOSED TO PERSONS NOT HAVING NEED OF SUCH DISCLOSURE CONSISTENT WITH THE PURPOSE OF THE LOAN. THE DOCUMENT MUST BE RETURNED TO TANGENT ENVIRONMENTAL TECHNOLOGIES UPON REQUEST AND IN ALL EVENTS UPON COMPLETION OF THE USE FOR WHICH IT WAS LOANED.

REV.	DATE	DESCRIPTION	BY	CHK.
0	JAN 15/08	AS BUILT	AY	~
~	~	~	~	~
~	~	~	~	~



ENVIRONMENTAL TECHNOLOGIES LTD.

**TANGENT ENVIRONMENTAL TECHNOLOGIES LTD.**  
 Bay A, 1007 55 Ave. NE  
 Calgary, AB. Canada  
 T2E 6W1  
 403.730.3410  
 www.tangentot.com

**CASCADE RECOVERY UNIT**  
 TANGENT

SCALE: NTS	DATE: JANUARY 15, 2008	DWN.: AY
QUOTE: ~	JOB NO.: J-1849	
SHEET: 1 OF 1	DWG.NO.: 1849-ISO-A	

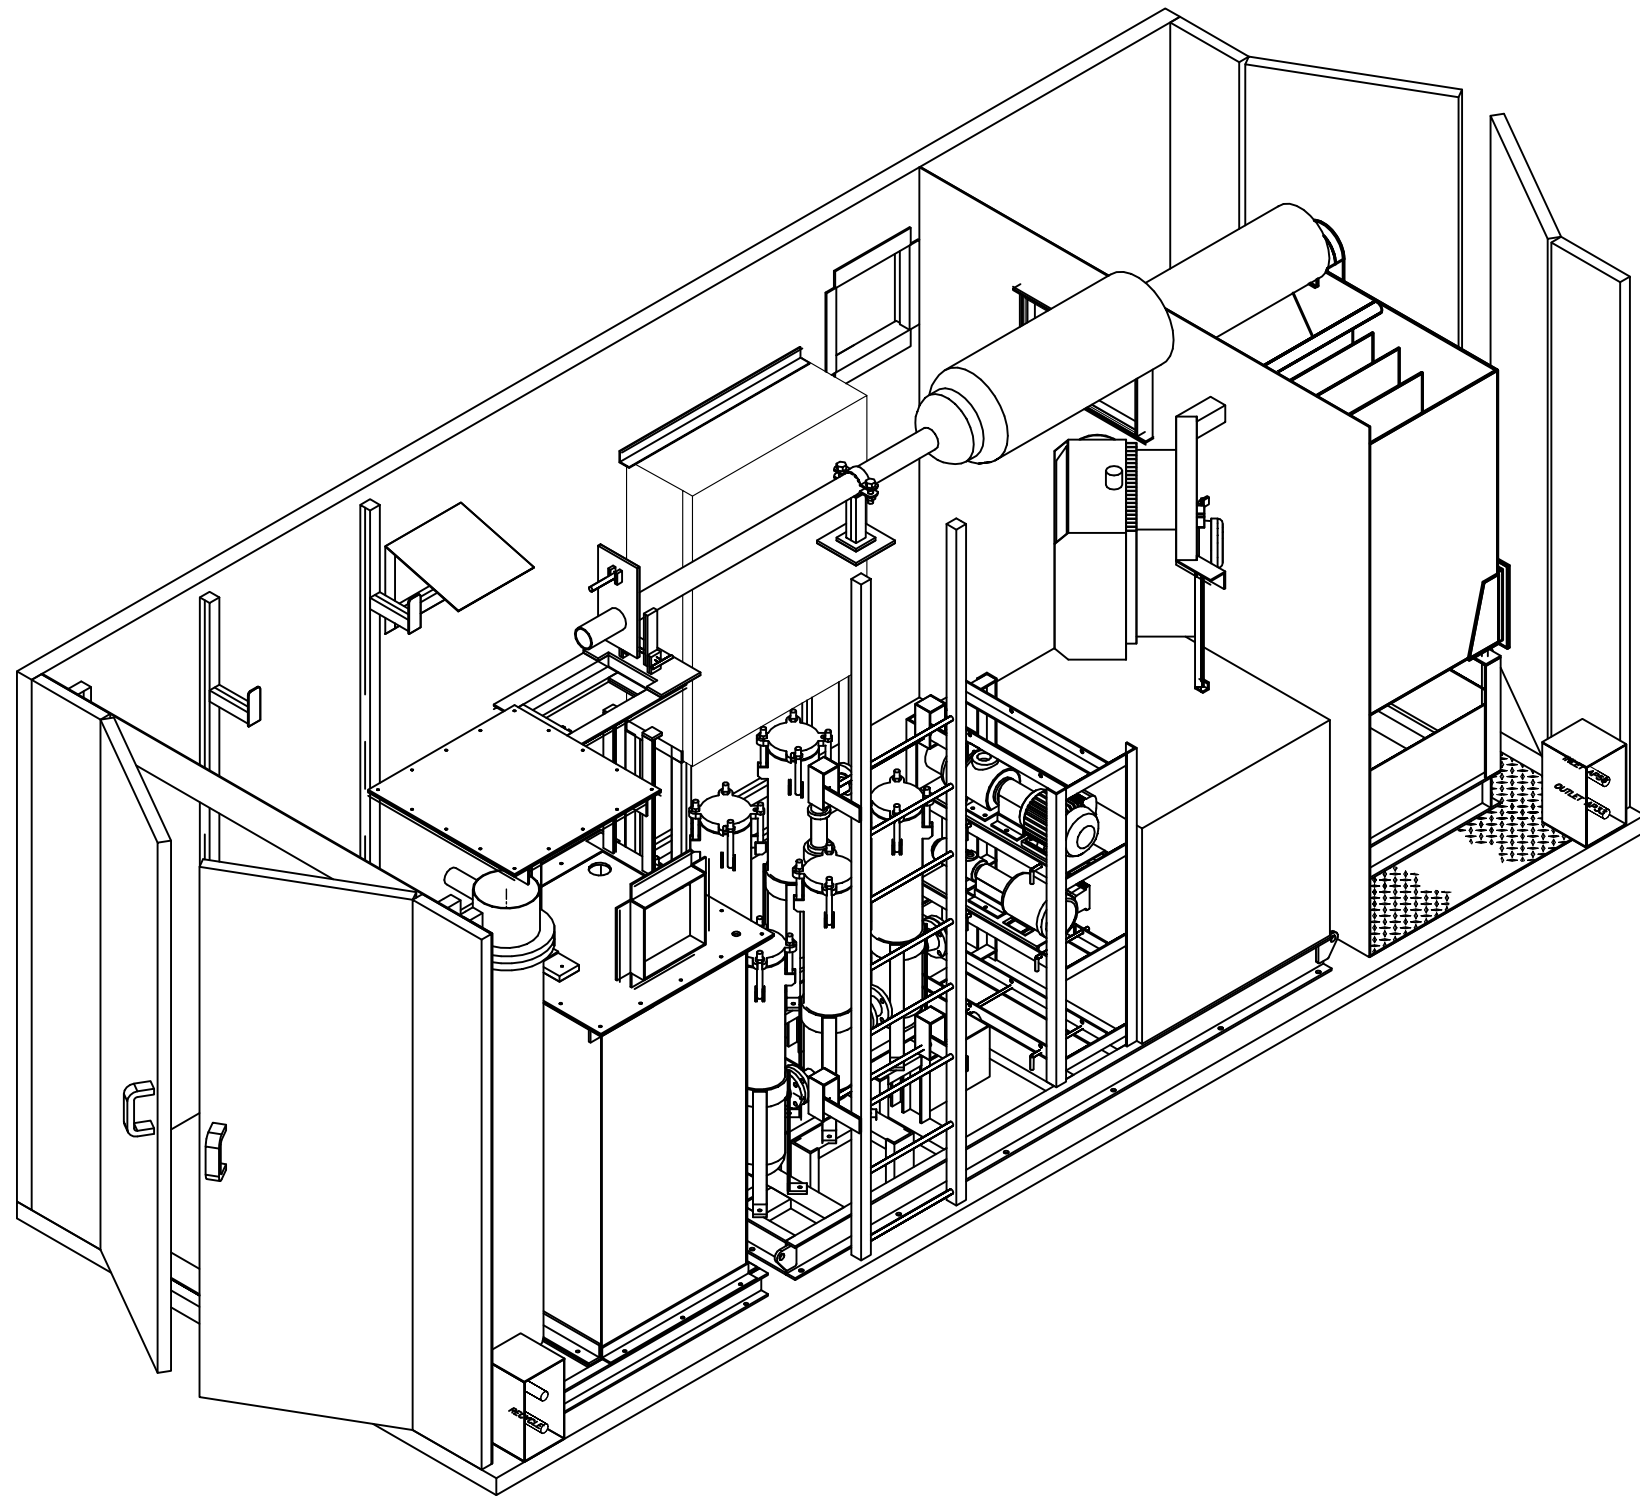

THIS DRAWING CONTAINS TANGENT ENVIRONMENTAL TECHNOLOGIES PROPRIETARY AND CONFIDENTIAL INFORMATION AND IS LOANED FOR LIMITED PURPOSES ONLY AND REMAINS THE PROPERTY OF TANGENT ENVIRONMENTAL TECHNOLOGIES. IT MAY NOT BE REPRODUCED IN WHOLE OR IN PART WITHOUT THE WRITTEN PERMISSION OF TANGENT ENVIRONMENTAL TECHNOLOGIES AND MUST NOT BE DISCLOSED TO PERSONS NOT HAVING NEED OF SUCH DISCLOSURE CONSISTENT WITH THE PURPOSE OF THE LOAN. THE DOCUMENT MUST BE RETURNED TO TANGENT ENVIRONMENTAL TECHNOLOGIES UPON REQUEST AND IN ALL EVENTS UPON COMPLETION OF THE USE FOR WHICH IT WAS LOANED.

REV.	DATE	DESCRIPTION	BY	CHK.
0	JAN 15/08	AS BUILT	AY	~
~	~	~	~	~
~	~	~	~	~
ENVIRONMENTAL TECHNOLOGIES LTD.

**TANGENT ENVIRONMENTAL TECHNOLOGIES LTD.**

Bay A, 1007 55 Ave. NE

Calgary, AB.

Canada

T2E 6W1

403.730.3410


www.tangentot.com

**SEAFREIGHT CONTAINER**

TANGENT

~  
~

SCALE: NTS	DATE: JANUARY 15, 2008	DWN.: AY
QUOTE: ~	JOB NO.: J-1849	
SHEET: 1 OF 1	DWG.NO.: 1849-ISO-B	

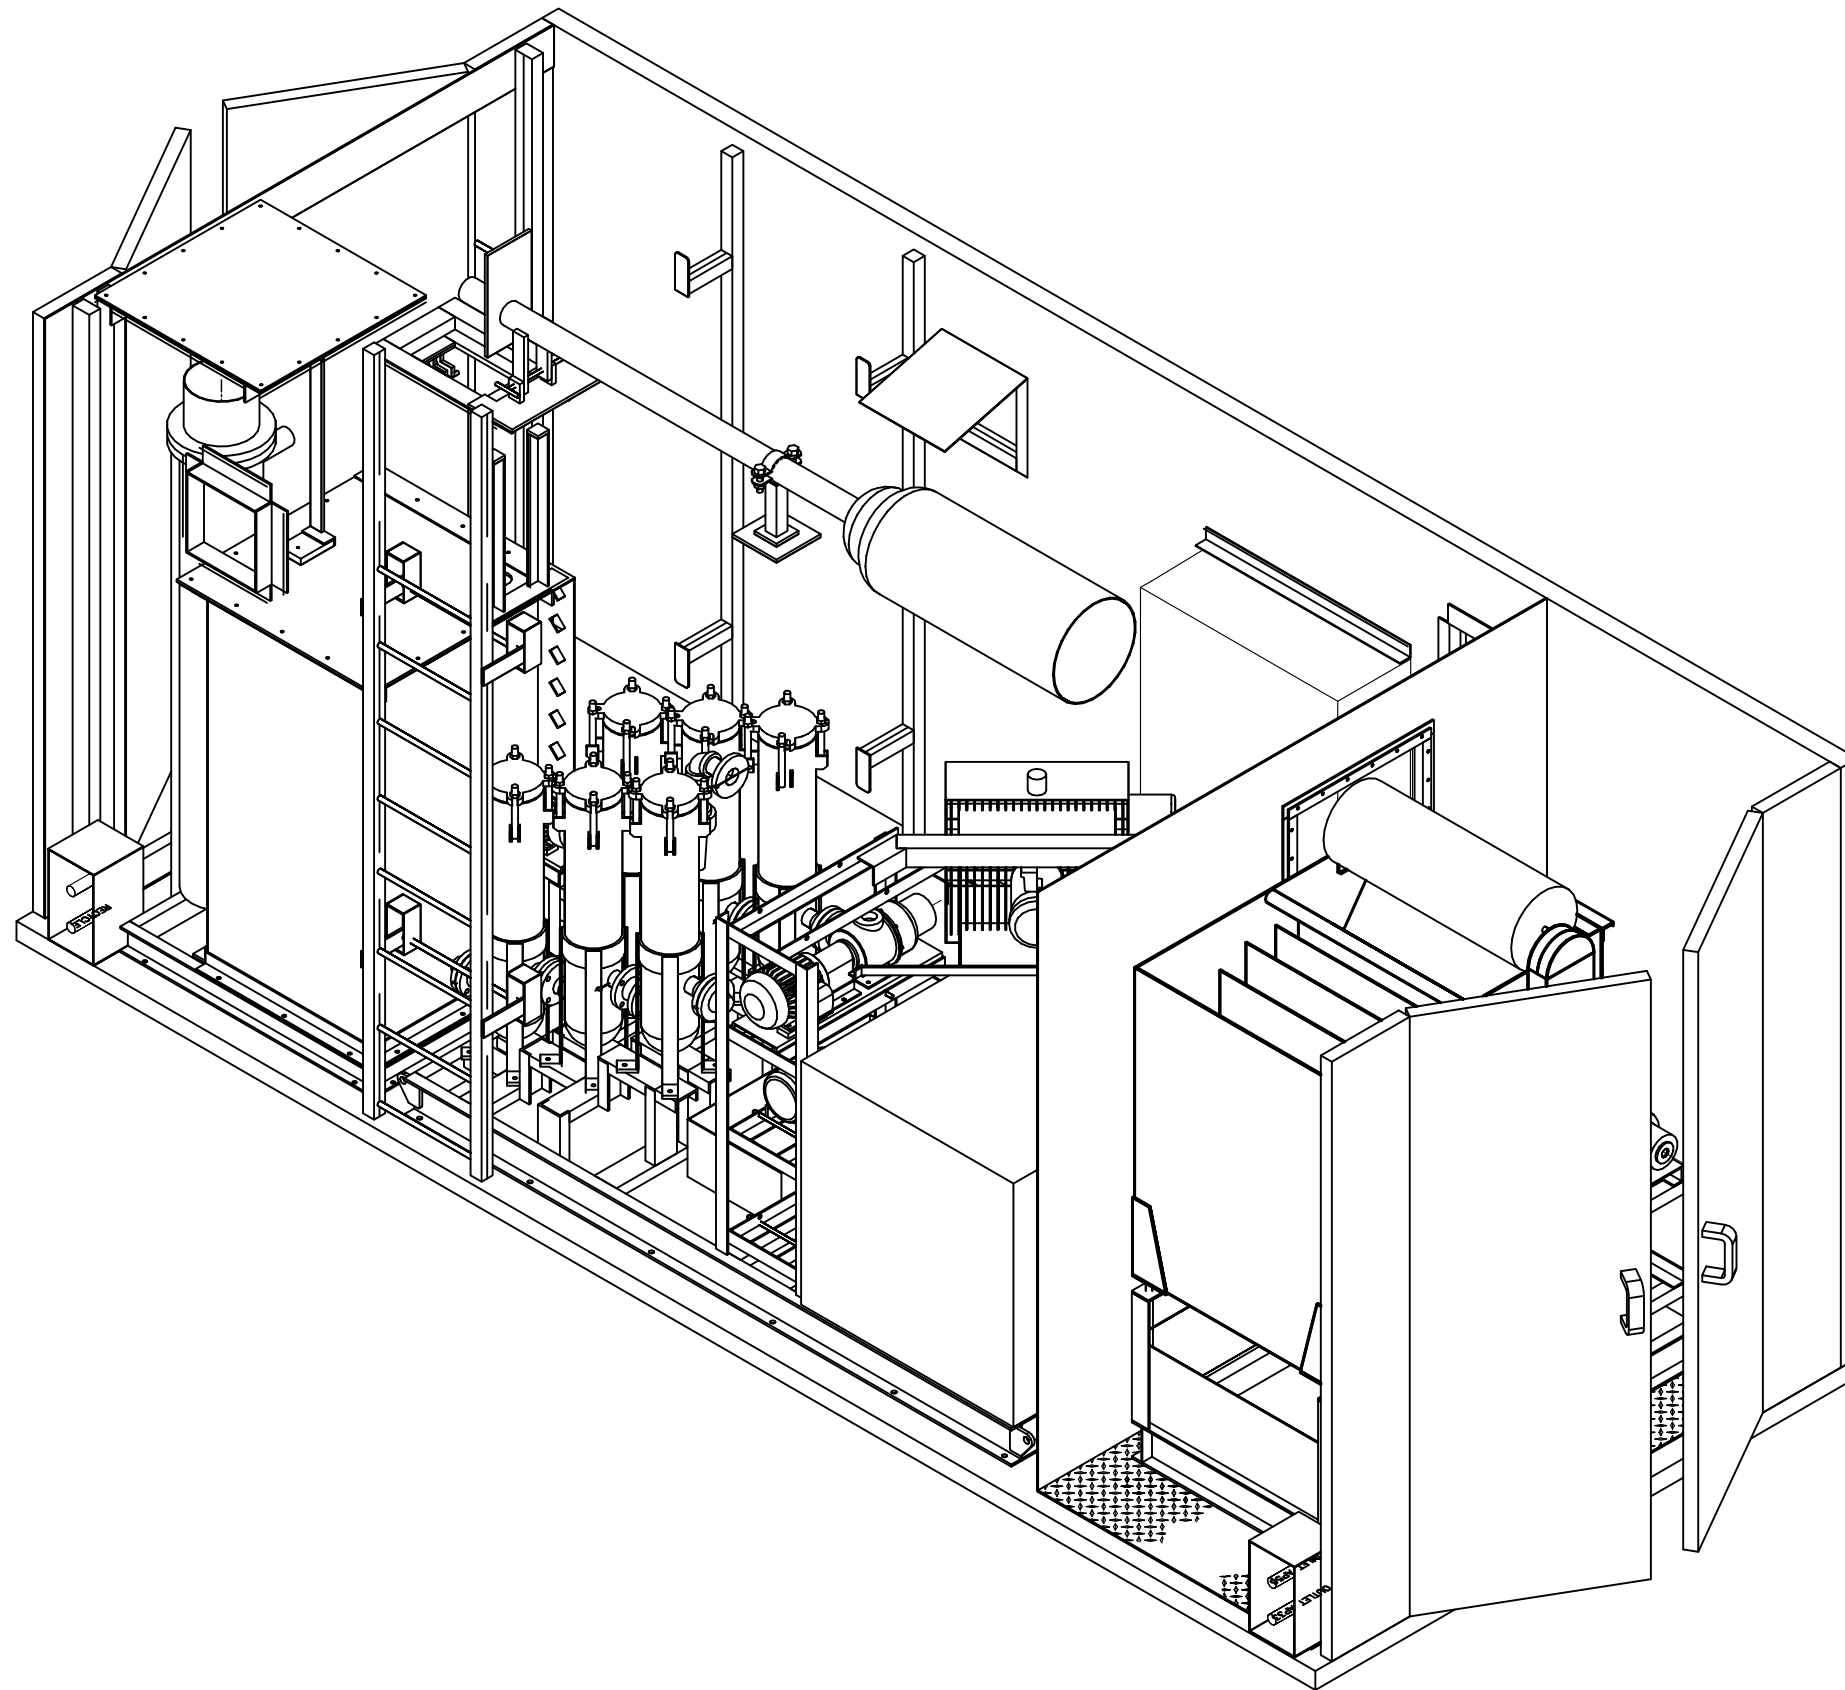

THIS DRAWING CONTAINS TANGENT ENVIRONMENTAL TECHNOLOGIES PROPRIETARY AND CONFIDENTIAL INFORMATION AND IS LOANED FOR LIMITED PURPOSES ONLY AND REMAINS THE PROPERTY OF TANGENT ENVIRONMENTAL TECHNOLOGIES. IT MAY NOT BE REPRODUCED IN WHOLE OR IN PART WITHOUT THE WRITTEN PERMISSION OF TANGENT ENVIRONMENTAL TECHNOLOGIES AND MUST NOT BE DISCLOSED TO PERSONS NOT HAVING NEED OF SUCH DISCLOSURE CONSISTENT WITH THE PURPOSE OF THE LOAN. THE DOCUMENT MUST BE RETURNED TO TANGENT ENVIRONMENTAL TECHNOLOGIES UPON REQUEST AND IN ALL EVENTS UPON COMPLETION OF THE USE FOR WHICH IT WAS LOANED.

REV.	DATE	DESCRIPTION	BY	CHK.
0	JAN 15/08	AS BUILT	AY	~
~	~	~	~	~
~	~	~	~	~
ENVIRONMENTAL TECHNOLOGIES LTD

**TANGENT ENVIRONMENTAL TECHNOLOGIES LTD.**

Bay A, 1007 55 Ave. NE

Calgary, AB.  
Canada

T2E 6W1

403.730.3410

www.tangentot.com

**SEAFREIGHT CONTAINER**

TANGENT

~  
~

SCALE: NTS	DATE: JANUARY 15, 2008	DWN.: AY
QUOTE: ~	JOB NO.: J-1849	
SHEET: 1 OF 1	DWG.NO.: 1849-ISO-B	